

STATE OF UTAH
DEPARTMENT OF NATURAL RESOURCES
DIVISION OF OIL, GAS AND MINING
 1594 West North Temple - Suite 1210
 Box 145801
 Salt Lake City, Utah 84114-5801
 Telephone: (801) 538-5291
 Fax: (801) 359-3940

RECEIVED

JAN 30 2015

DIV. OF OIL, GAS & MINING

LARGE MINING OPERATIONS PROGRESS REPORT
January 1, 2014 to December 31, 2014

The information required in this form is based on provisions of the Mined Land Reclamation Act, Title 40-8, and the R647 rules under the Utah Minerals Regulatory Program.

1. Mine Permit Number: M/049/0011
2. Mine Name: Pelican Point Quarry
3. Name of Operator/Permittee: Geneva Rock Products, Inc.

Note: If Operator's address, company representative or phone number have changed, please provide a replacement page for the Notice of Intention together with form MR-REV available on the Division's web page at https://fs.ogm.utah.gov/pub/mines/minerals_related/forms/MR-REV.pdf.

4. Report the gross amount of ore mined and waste moved:

Gross Ore Mined 331,030 Tons, or _____ yd³
 Waste Material Moved 0 Tons, or _____ yd³

5. Disturbance at the end of 2013 161 Acres
 New Disturbance Created during 2014 0 Acres
 Area Reclaimed and Fully Released during 2014 0 Acres
 Total Disturbed Area at the end of 2014 161 Acres*
 Permitted/Bonded Acreage 217 Acres

*The total disturbed area should not be greater than the permitted/bonded acreage

6. Briefly describe the reclamation work performed during the past year. (Submit form MR-SITE (https://fs.ogm.utah.gov/pub/mines/minerals_related/forms/MR-SITE.pdf) to apply for full or partial bond/site release). Attach additional sheets if needed.

No reclamation work has been performed during this period.

7. For large mines, include an updated map depicting surface disturbance and reclamation performed during the year (Rule R647-4-105).


I hereby certify, under penalties of law, the information provided in this report is true and correct to the best of my knowledge and belief.

Name (Typed or Print): Brent R. Sumsion
 Title of Operator: Properties and Environmental Manager
 Signature of Operator: [Signature]
 Date: Jan. 30, 2015

RECEIVED

JAN 30 2015

DIV. OF OIL, GAS & MINING

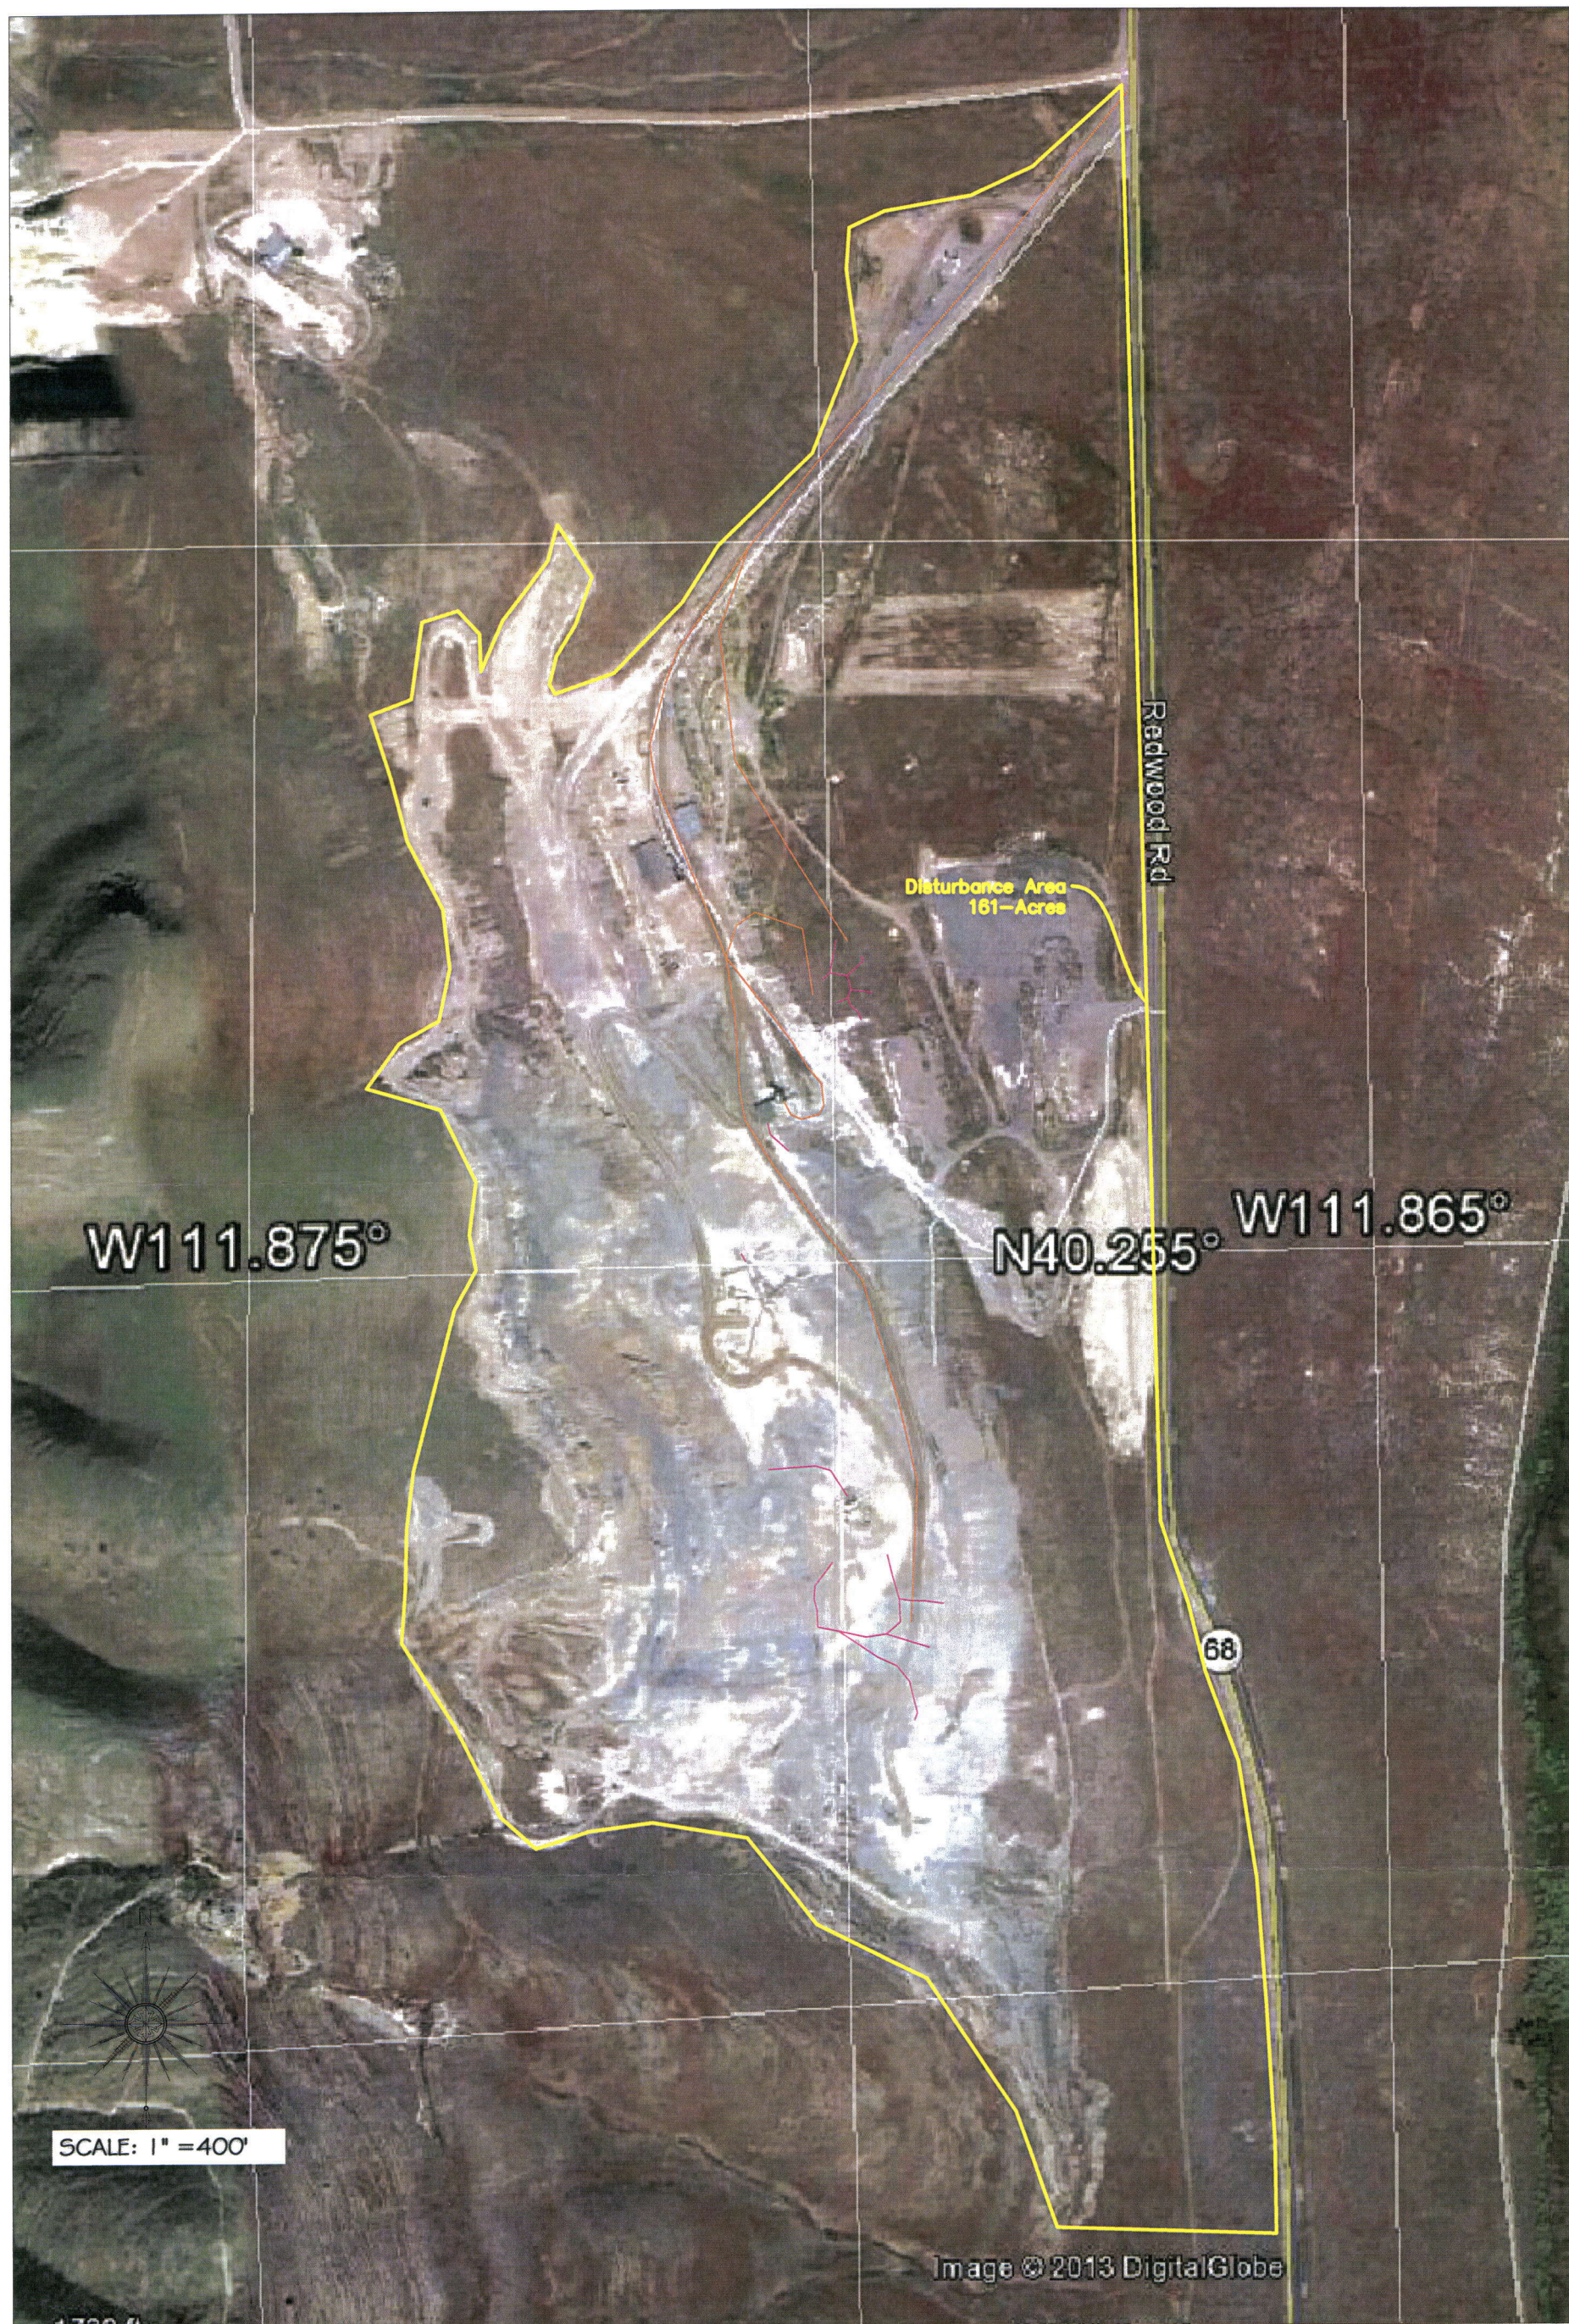

Drawn: B SUMSION	TITLE: Pelican Point Quarry Disturbance Footprint: 2013	Engineer:				
Checked: BS/CC						
Approved:						
Date: 1/30/15	ISSUED FOR INTERNAL REVIEW	Revision: 00	NO.	DATE:	DESCRIPTION:	BY:
Dwg. No.						

Geneva Rock Products, Inc.
Pelican Point Quarry

**GENEVA
ROCK**
PRODUCTS, INC.

Geneva Rock Products, Inc.
P.O. Box 538
Orem, Utah 84059
801-765-7800